


A	RELATIONSHANDLING	2008-03-19	OW
BET	ANT	ÄNDRINGEN AVSER	DATUM SIGN



RELATIONSHANDLING

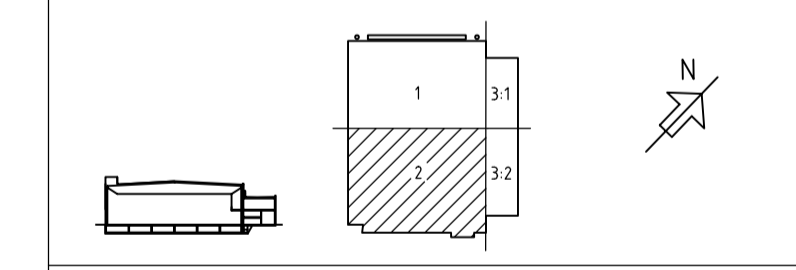


**white**  
White arkitekter AB  
Trädgårdsgatan 14  
SE 702 12 Örebro  
tel +46(0)19-6702200  
fax +46(0)19-6702222  
www.white.se

A	WHITE ARKITEKTER AB	TEL 019 - 670 22 00	FAX 019 - 670 22 22
K	WSP BYGGPROJEKTERING	TEL 019 - 17 89 50	FAX 019 - 13 32 00
V	ÅF INFRASTRUKTUR AB	TEL 019 - 601 46 00	FAX 019 - 611 45 92
W	RÖRPLANERING AB	TEL 019 - 472 14 40	
E	ÅKESSON ELTEKNIK AB	TEL 019 - 26 26 99	FAX 019 - 26 32 69
S1	ALBACON AB	TEL 031 - 706 89 20	FAX 031 - 706 89 21
S2	INGEMANSSONS TECHNOLOGY AB	TEL 08 - 709 20 00	FAX 08 - 709 20 10

UPPDRAG NR 81 030100  
RITAD/KONSTR AV SAX  
ANSVARIG SVEN GUNNARSON  
DATUM 2007-05-21  
HANDLÄGGARE

CONVENTUM, MASSHALL  
KV. STINSEN 19, ÖREBRO

PLAN 3, DEL 2 (+17.26)  
SKALA A1: 1:100 A3: 1:200  
NUMMER A-40.1-1032  
BET A

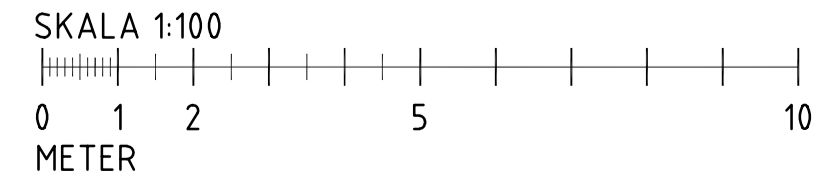

Modellförfattare: A  
Filen: A04\_P02  
Datum: 2008-04-07