


A	RELATIONSHANDLING	2008-03-19	OW
BET	ANT	ÄNDRINGEN AVSER	DATUM
			SIGN



RELATIONSHANDLING

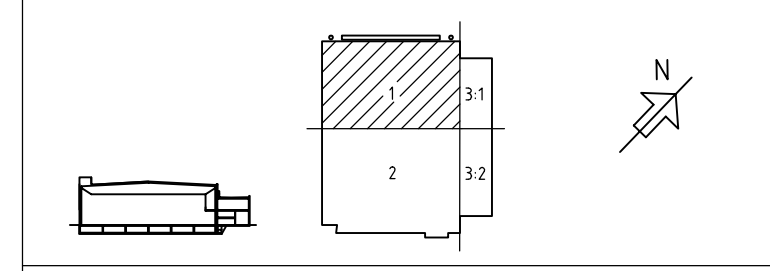


white
White arkitekter AB
Trädgårdsgatan 14
SE 702 12 Örebro
tel +46(0)19-6702200
fax +46(0)19-6702222
www.white.se

A	WHITE ARKITEKTER AB	TEL 019 - 670 22 00	FAX 019 - 670 22 22
K	WSP BYGGPROJEKTERING	TEL 019 - 17 89 50	FAX 019 - 13 32 00
V	ÅF INFRASTRUKTUR AB	TEL 019 - 601 46 00	FAX 019 - 611 45 92
W	RÖRPLANERING AB	TEL 019 - 472 14 40	
E	ÅKESSON ELTEKNIK AB	TEL 019 - 26 26 99	FAX 019 - 26 32 69
S1	ALBACON AB	TEL 031 - 706 89 20	FAX 031 - 706 89 21
S2	INGEMANSSONS TECHNOLOGY AB	TEL 08 - 709 20 00	FAX 08 - 709 20 10

UPPDRAG NR	81 030100	RITAD/INSTR AV	SAX	HANDLÄGGARE	
DATUM	2007-05-21	ANSVARIG	SVEN GUNNARSON		

CONVENTUM, MASSHALL
KV. STINSEN 19, ÖREBRO

PLAN 4, DEL 1 (+20.17)	SKALA	NUMMER	BET
	A1: 1:100	A-40.1-1041	A
	A3: 1:200		

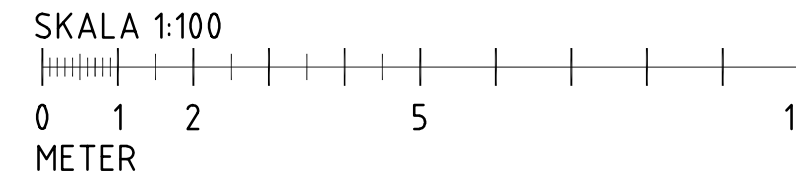

Modellförfattare: A
Filen: A01.dwg
Datum: 2008-03-08