


Modellversion
 Filnamn A4_P46
 Datum 2008-04-08

Externa referenser: ...\\P\MODELL\STAMP.DWG ...\\A\AMODELL\A40P02.DWG

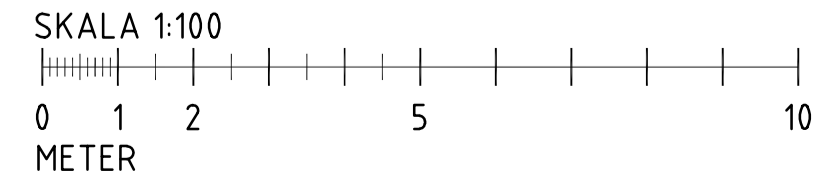

A	RELATIONSHANDLING	2008-03-19	OW
BET	ANT	ÄNDRINGEN AVSER	DATUM SIGN
RELATIONSHANDLING			
White arkitekter AB Trädgårdsgatan 14 SE 702 12 Örebro tel +46(0)19-6702200 fax +46(0)19-6702222 www.white.se			
A	WHITE ARKITEKTER AB	TEL 019 - 670 22 00	FAX 019 - 670 22 22
K	WSP BYGGPROJEKTERING	TEL 019 - 17 89 50	FAX 019 - 13 32 00
V	ÄF INFRASTRUKTUR AB	TEL 019 - 601 46 00	FAX 019 - 611 45 92
W	RÖRPLANERING AB	TEL 019 - 472 14 40	
E	ÅKESSON ELTEKNIK AB	TEL 019 - 26 26 99	FAX 019 - 26 32 69
S1	ALBACON AB	TEL 031 - 706 89 20	FAX 031 - 706 89 21
S2	INGEMANSSONS TECHNOLOGY AB	TEL 08 - 709 20 00	FAX 08 - 709 20 10
UPPROG NR	81 030100	RITAD/KONSTR AV	HANDLÄGGARE
DATUM	2007-05-21	ANSVARIG	SVEN GUNNARSON
CONVENTUM, MASSHALL KV. STINSEN 19, ÖREBRO			
PLAN 7, DEL 1, YTTERTAK			
SKALA	NUMMER	BET	
A1: 1:100	A-40.1-1071	A	
A3: 1:200			

PLO: 2008-05-27 16:51 R:\Conventum\030100\RELA\TIDSHANDLING\A1\bet\A401_070.dwg \$low