


BET	ANT	ÄNDRINGEN AVSER	DATUM	SIGN



RELATIONSHANDLING 080507

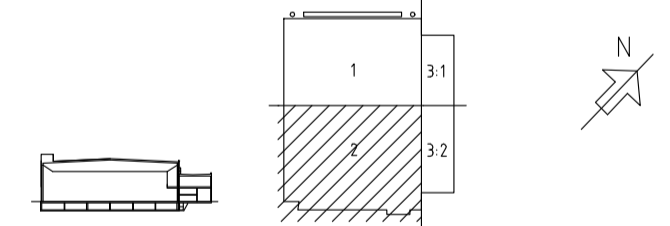

Åkessons elteknik ab

Leif Åkessons elteknik ab Tunnilandsvägen 5, 2tr Box 1447, 701 14 Örebro
Telefon 019-26 26 99 Mobil 070-066 26 99 Telefax 019-26 32 69


A	WHITE ARKITEKTER AB	TEL 019 - 470 22 00	FAX 019 - 470 22 22
K	WSP BYGGPROJEKTERING	TEL 019 - 17 89 50	FAX 019 - 13 32 00
V	ÄF INFRASTRUKTUR AB	TEL 019 - 601 46 00	FAX 019 - 611 45 92
W	RÖRPLANERING AB	TEL 019 - 472 14 40	
E	ÅKESSON ELTEKNIK AB	TEL 019 - 26 26 99	FAX 019 - 26 32 69
S1	ALBACON AB	TEL 031 - 706 89 20	FAX 031 - 706 89 21
S2	INGEMANSSONSSON TECHNOLOGY AB	TEL 08 - 709 20 00	FAX 08 - 709 20 10

LUPPRAG NR 0701-1 RITAD/KONSTR AV DC HANDLAGGARE L ÅKESSON
DATUM 2007-05-11 ANSVARIG LEIF ÅKESSON

CONVENTUM, MASSHALL
KV. STINSEN 19, ÖREBRO

PLAN 2 - KRAFT

SKALA	NUMMER	BET
A1: 1:100	E62-01-2012	
A3: 1:200		

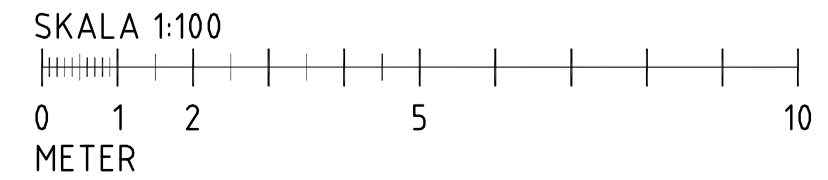

Modellfilisversion
Filnamn E62P02
Datum 2008-05-07

Modellfilisversion
Filnamn A01_P02
Datum 2007-07-02