



Modellfilisversion
Filnam E62P04
Datum 2008-05-07

Modellfilisversion
Filnam A62P04
Datum 2007-07-02

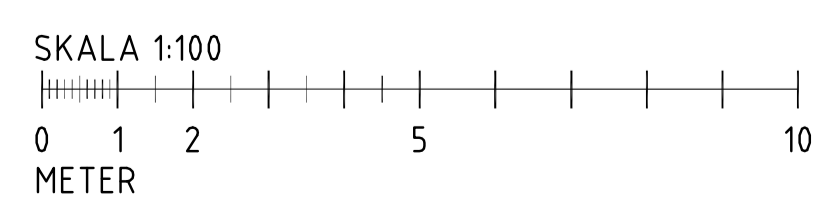

BET	ANT	ÄNDRINGEN AVSER	DATUM	SIGN
-----	-----	-----------------	-------	------

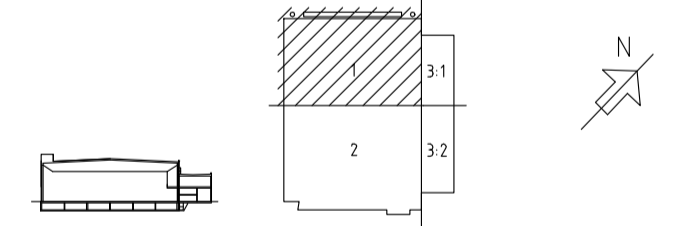

RELATIONSHANDLING 080507



Åkesson elteknik ab

Leif Åkesson elteknik ab Tunnlundsgatan 5, 2tr Box 1447, 701 14 Örebro
Telefon 019-26 26 99 Mobil 070-066 26 99 Telefax 019-26 32 69

A	WHITE ARKITEKTER AB	TEL 019 - 470 22 00	FAX 019 - 470 22 32
K	WSP BYGGPROJEKTERING	TEL 019 - 17 89 50	FAX 019 - 13 32 00
V	ÅF INFRASTRUKTUR AB	TEL 019 - 60146 00	FAX 019 - 61145 92
W	RÖRPLANERING AB	TEL 019 - 472 14 40	
E	ÅKESSON ELTEKNIK AB	TEL 019 - 26 26 99	FAX 019 - 26 32 69
S1	ALBACON AB	TEL 031 - 706 89 20	FAX 031 - 706 89 21
S2	INGEMANSSONS TECHNOLOGY AB	TEL 08 - 709 20 00	FAX 08 - 709 20 10

UPPDRAG NR	0701-1	RITAD/KONSTR AV	DC	HANDLAGGARE	L ÅKESSON
DATUM	2007-05-11	ANSVARIG	LEIF ÅKESSON		

CONVENTUM, MASSHALL
KV. STINSEN 19, ÖREBRO

PLAN 4 - KRAFT

SKALA	NUMMER	BET
A1: 1:100 A3: 1:200	E62-01-4011	