



Modellfilisversion  
Filnamn: E62P06  
Datum: 2008-05-07

Modellfilisversion  
Filnamn: A01\_P06  
Datum: 2007-07-02

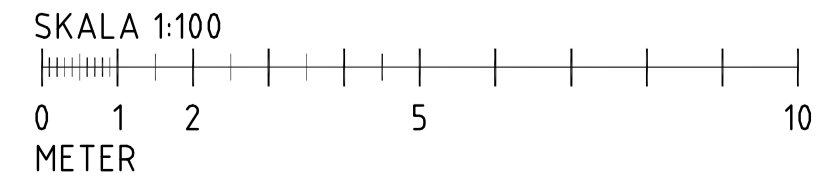

BET	ANT	ÄNDRINGEN AVSER	DATUM	SIGN
-----	-----	-----------------	-------	------

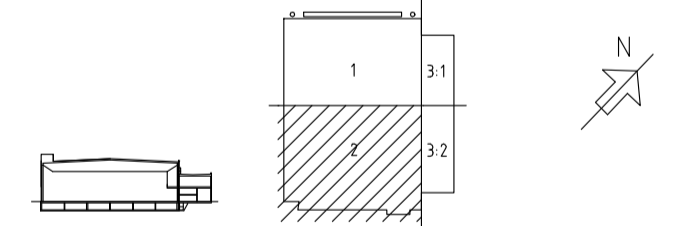

RELATIONSHANDLING 080507



Åkessons elteknik ab

Leif Åkessons elteknik ab, Tunnlundsgatan 5, 2tr, Box 1447, 701 14 Örebro  
Telefon 019-26 26 99 Mobil 070-066 26 99 Telefax 019-26 32 69

A	WHITE ARKITEKTER AB	TEL 019 - 470 22 00	FAX: 019 - 470 22 22
K	WSP BYGGPROJEKTERING	TEL 019 - 17 89 50	FAX: 019 - 13 32 00
V	ÅF INFRASTRUKTUR AB	TEL 019 - 60146 00	FAX: 019 - 61145 92
W	RÖRPLANERING AB	TEL 019 - 472 14 40	
E	ÅKESSON ELTEKNIK AB	TEL 019 - 26 26 99	FAX: 019 - 26 32 69
S1	ALBACON AB	TEL 031 - 706 89 20	FAX: 031 - 706 89 21
S2	INGEMANSSONS TECHNOLOGY AB	TEL 08-709 20 00	FAX: 08 - 709 20 10

UPPDRAG NR	RITAD/KONSTR AV	HANDLÄGGARE
0701-1	DC	L ÅKESSON
DATUM	ANSVARIG	
2007-05-11	LEIF ÅKESSON	

CONVENTUM, MASSHALL  
KV. STINSEN 19, ÖREBRO

PLAN 6 - KRAFT

SKALA	NUMMER	BET
A1: 1:100	E62-01-6012	
A3: 1:200		